
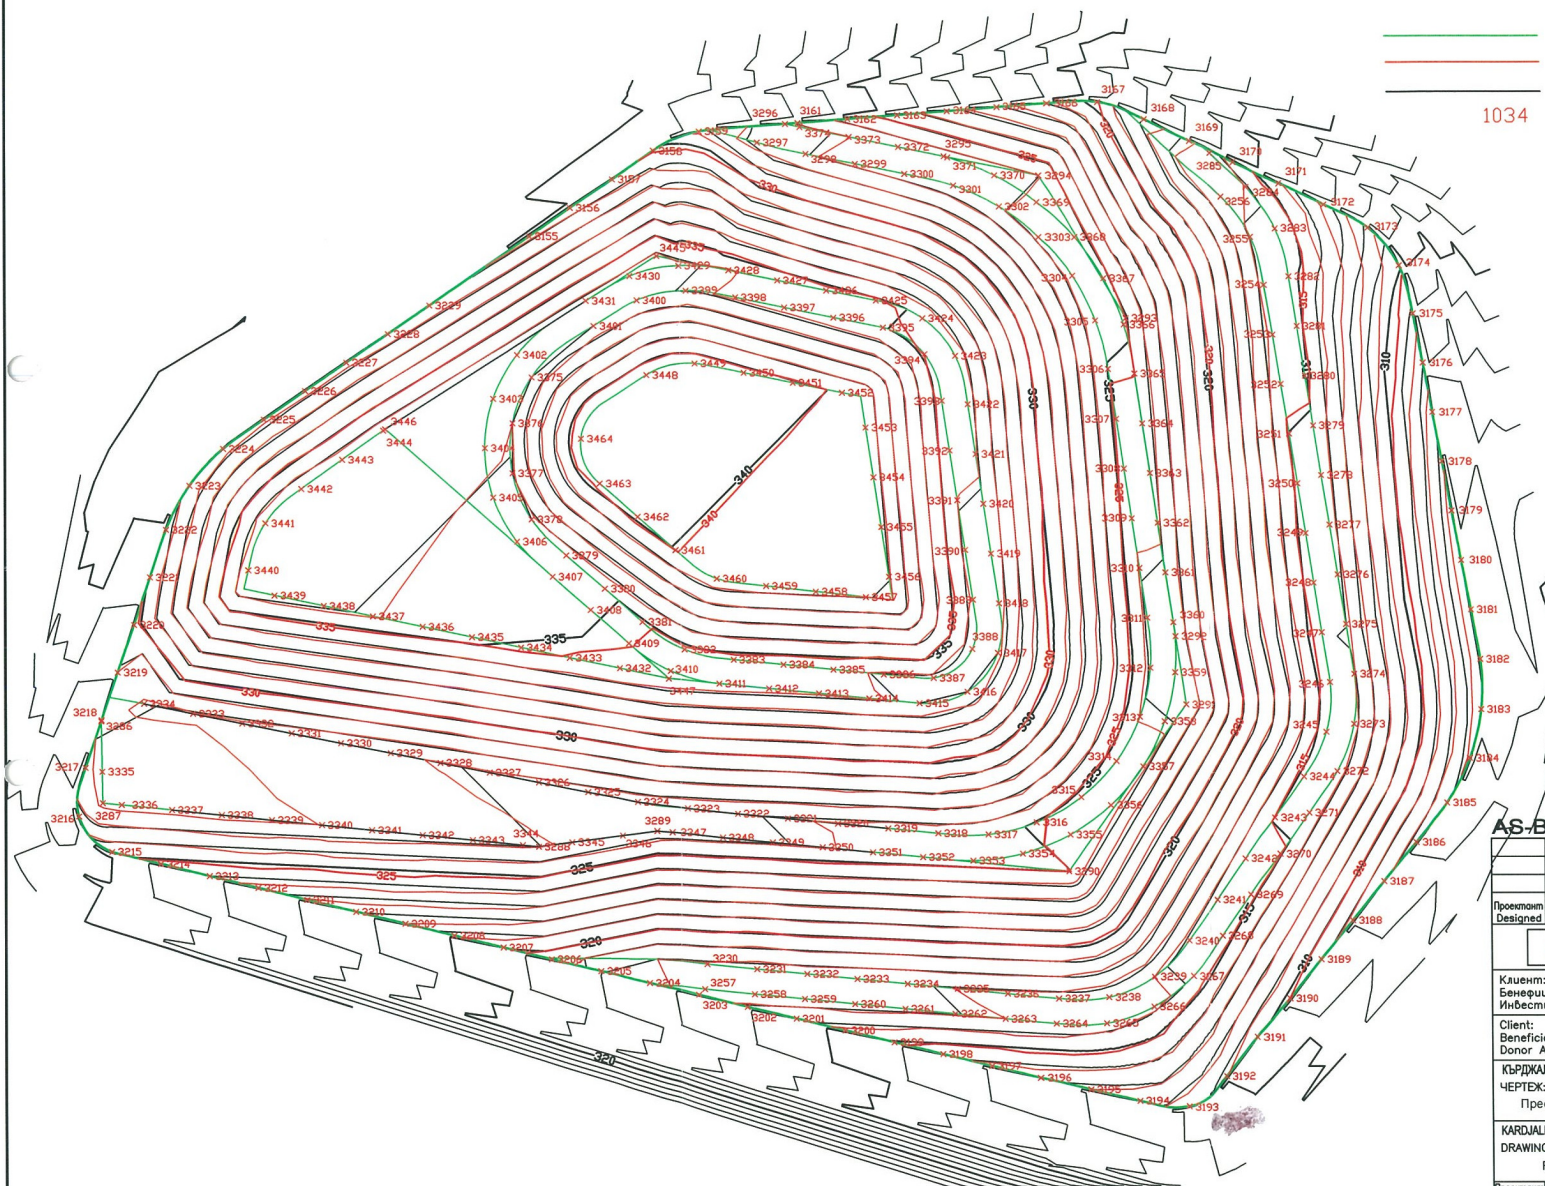


ЛЕГЕНДА:

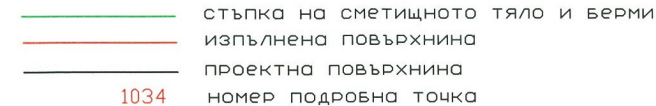

AS-BUILT DRAWING / ЕКЗЕКУТИВЕН ЧЕРТЕЖ

[illegible]